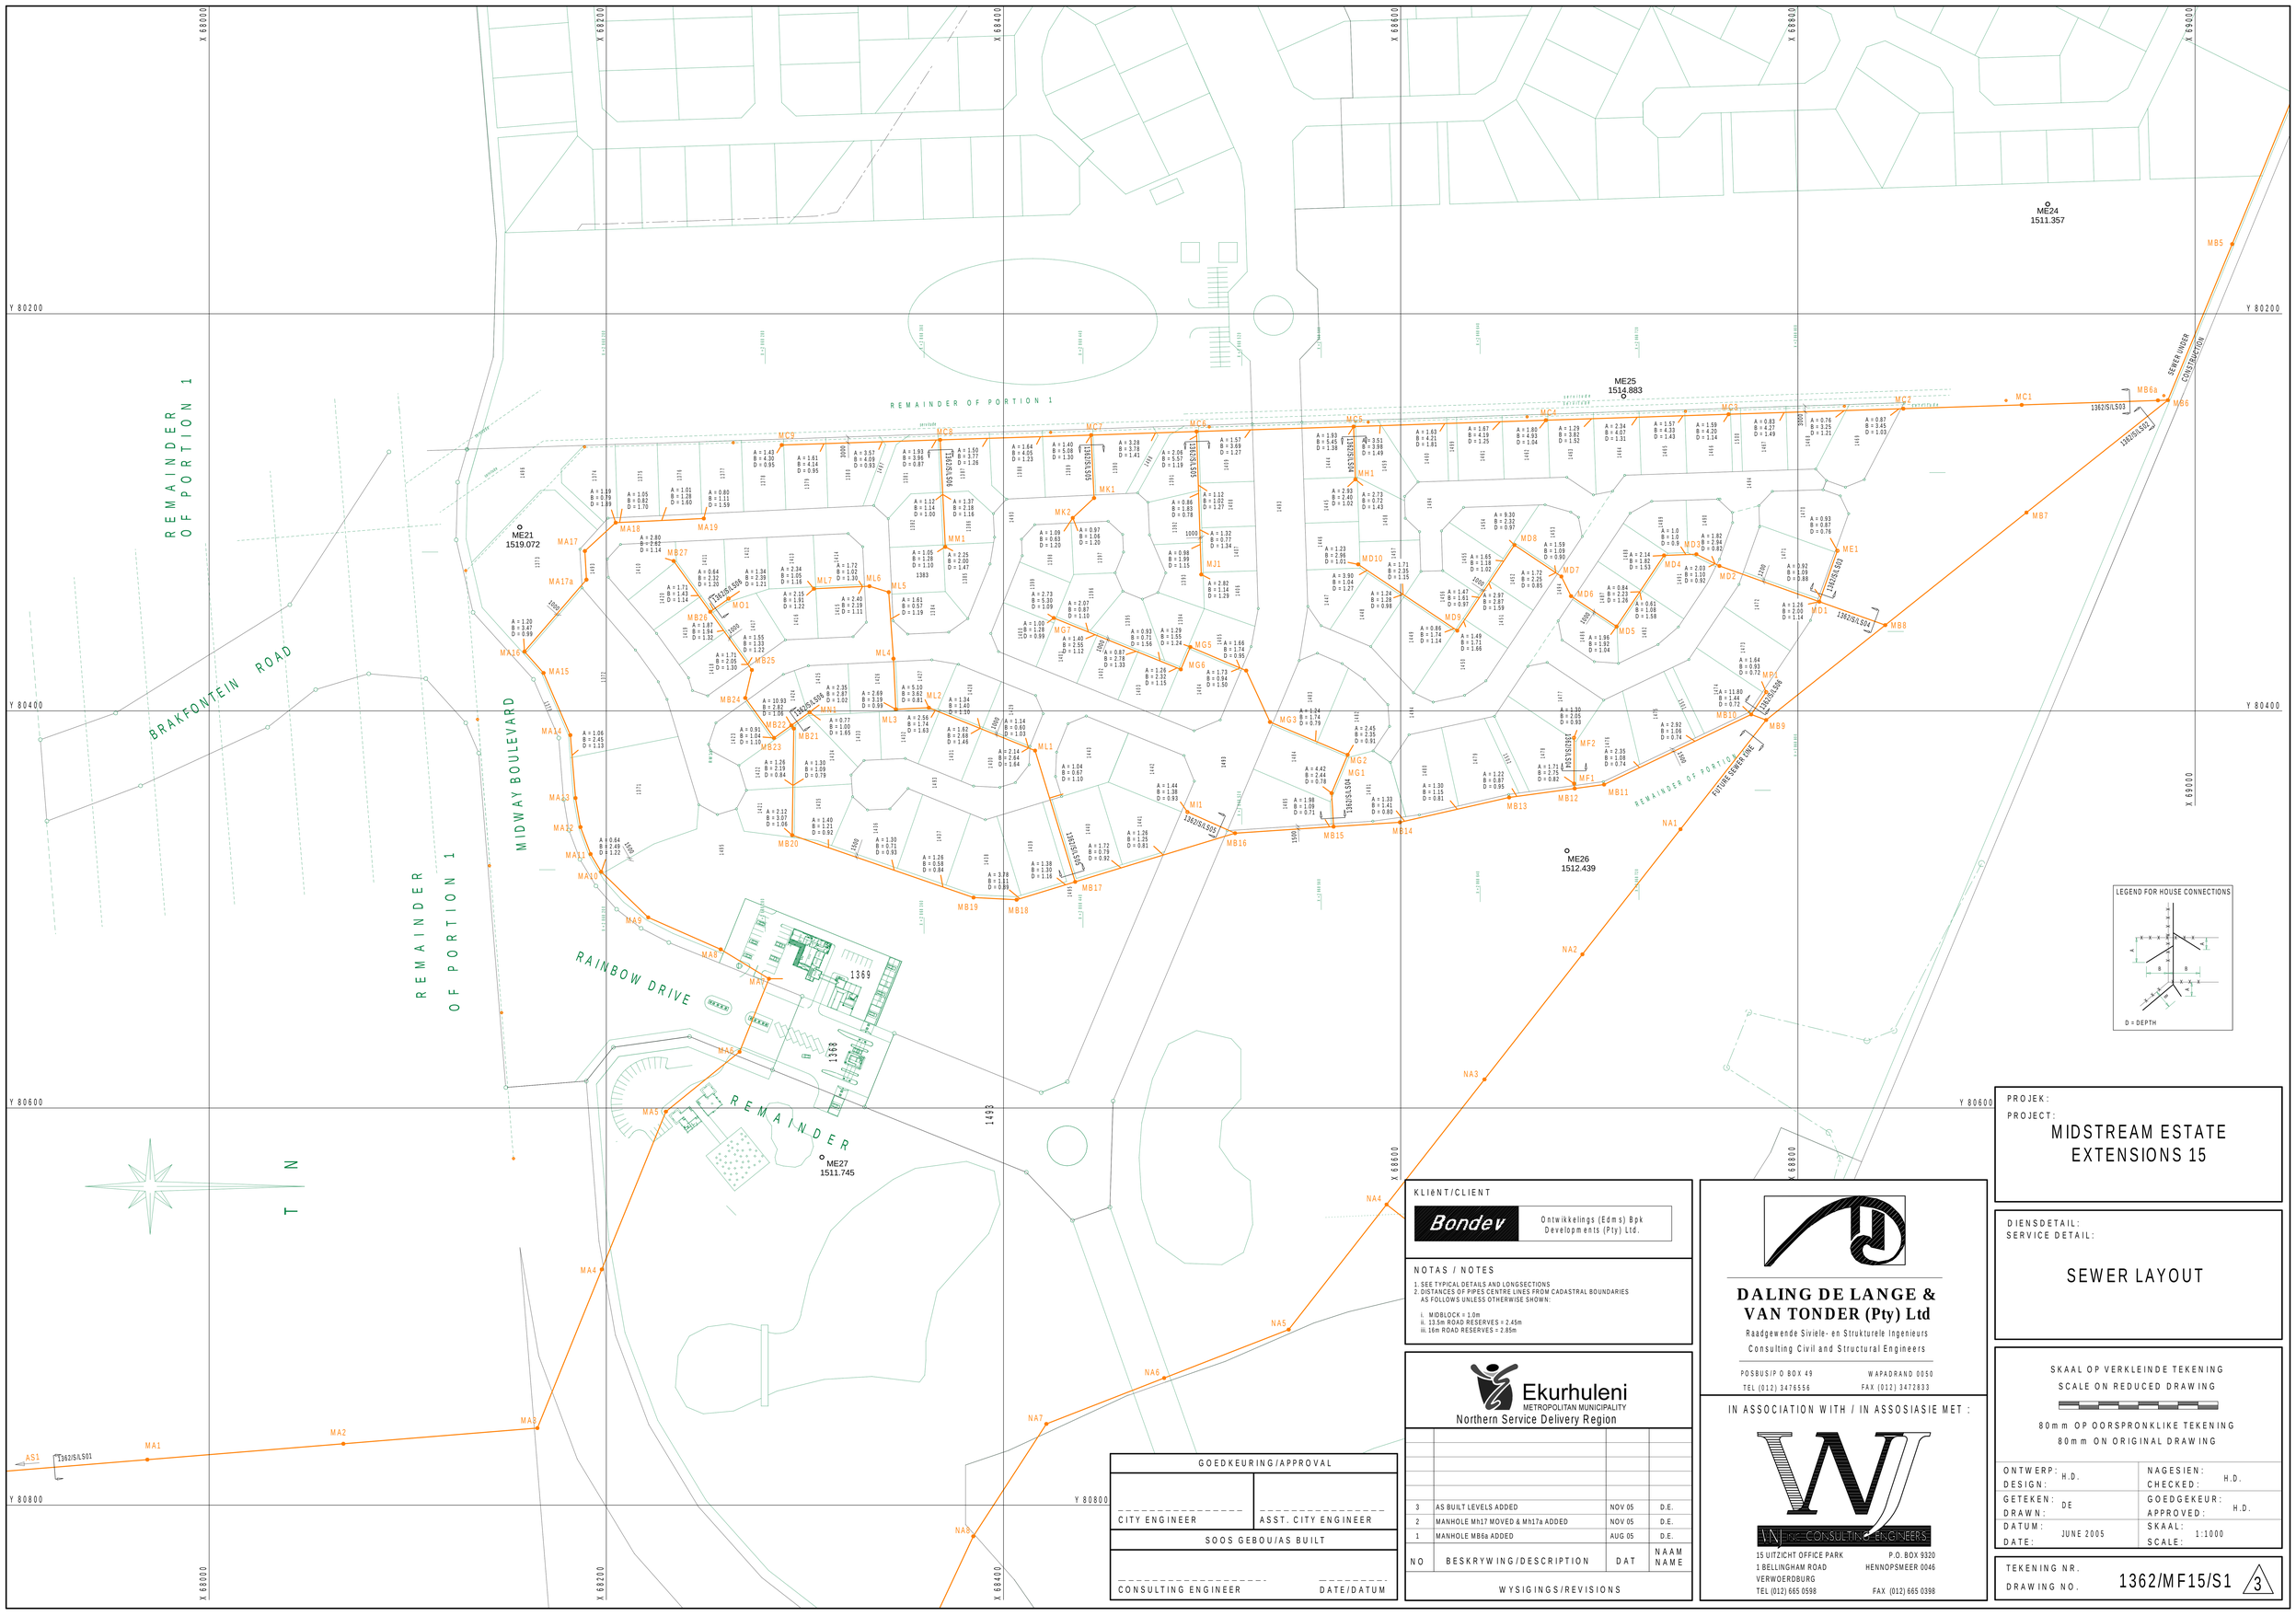

KLIËNT/CLIENT

Bondev — Ontwikkelings (Edms) Bpk / Developments (Pty) Ltd.

NOTAS / NOTES

1. SEE TYPICAL DETAILS AND LONGSECTIONS
2. DISTANCES OF PIPES CENTRE LINES FROM CADASTRAL BOUNDARIES AS FOLLOWS UNLESS OTHERWISE SHOWN:
   i. MIDBLOCK = 1.0m
   ii. 13.5m ROAD RESERVES = 2.45m
   iii. 16m ROAD RESERVES = 2.85m

Ekurhuleni
METROPOLITAN MUNICIPALITY
Northern Service Delivery Region

NO	BESKRYWING/DESCRIPTION	DAT	NAAM NAME
3	AS BUILT LEVELS ADDED	NOV 05	D.E.
2	MANHOLE Mh17 MOVED & Mh17a ADDED	NOV 05	D.E.
1	MANHOLE MB6a ADDED	AUG 05	D.E.

WYSIGINGS/REVISIONS

GOEDKEURING/APPROVAL

CITY ENGINEER | ASST. CITY ENGINEER

SOOS GEBOU/AS BUILT

CONSULTING ENGINEER | DATE/DATUM

DALING DE LANGE & VAN TONDER (Pty) Ltd
Raadgewende Siviele- en Strukturele Ingenieurs
Consulting Civil and Structural Engineers

POSBUS/P O BOX 49 — WAPADRAND 0050
TEL (012) 3476556 — FAX (012) 3472833

IN ASSOCIATION WITH / IN ASSOSIASIE MET :

WJ Inc CONSULTING ENGINEERS
15 UITZICHT OFFICE PARK, 1 BELLINGHAM ROAD, VERWOERDBURG — P.O. BOX 9320, HENNOPSMEER 0046
TEL (012) 665 0598 — FAX (012) 665 0398

PROJEK:
PROJECT:
MIDSTREAM ESTATE EXTENSIONS 15

DIENSDETAIL:
SERVICE DETAIL:
SEWER LAYOUT

SKAAL OP VERKLEINDE TEKENING
SCALE ON REDUCED DRAWING
80mm OP OORSPRONKLIKE TEKENING
80mm ON ORIGINAL DRAWING

ONTWERP: DESIGN:	H.D.	NAGESIEN: CHECKED:	H.D.
GETEKEN: DRAWN:	DE	GOEDGEKEUR: APPROVED:	H.D.
DATUM: DATE:	JUNE 2005	SKAAL: SCALE:	1:1000

TEKENING NR.
DRAWING NO. 1362/MF15/S1 — 3