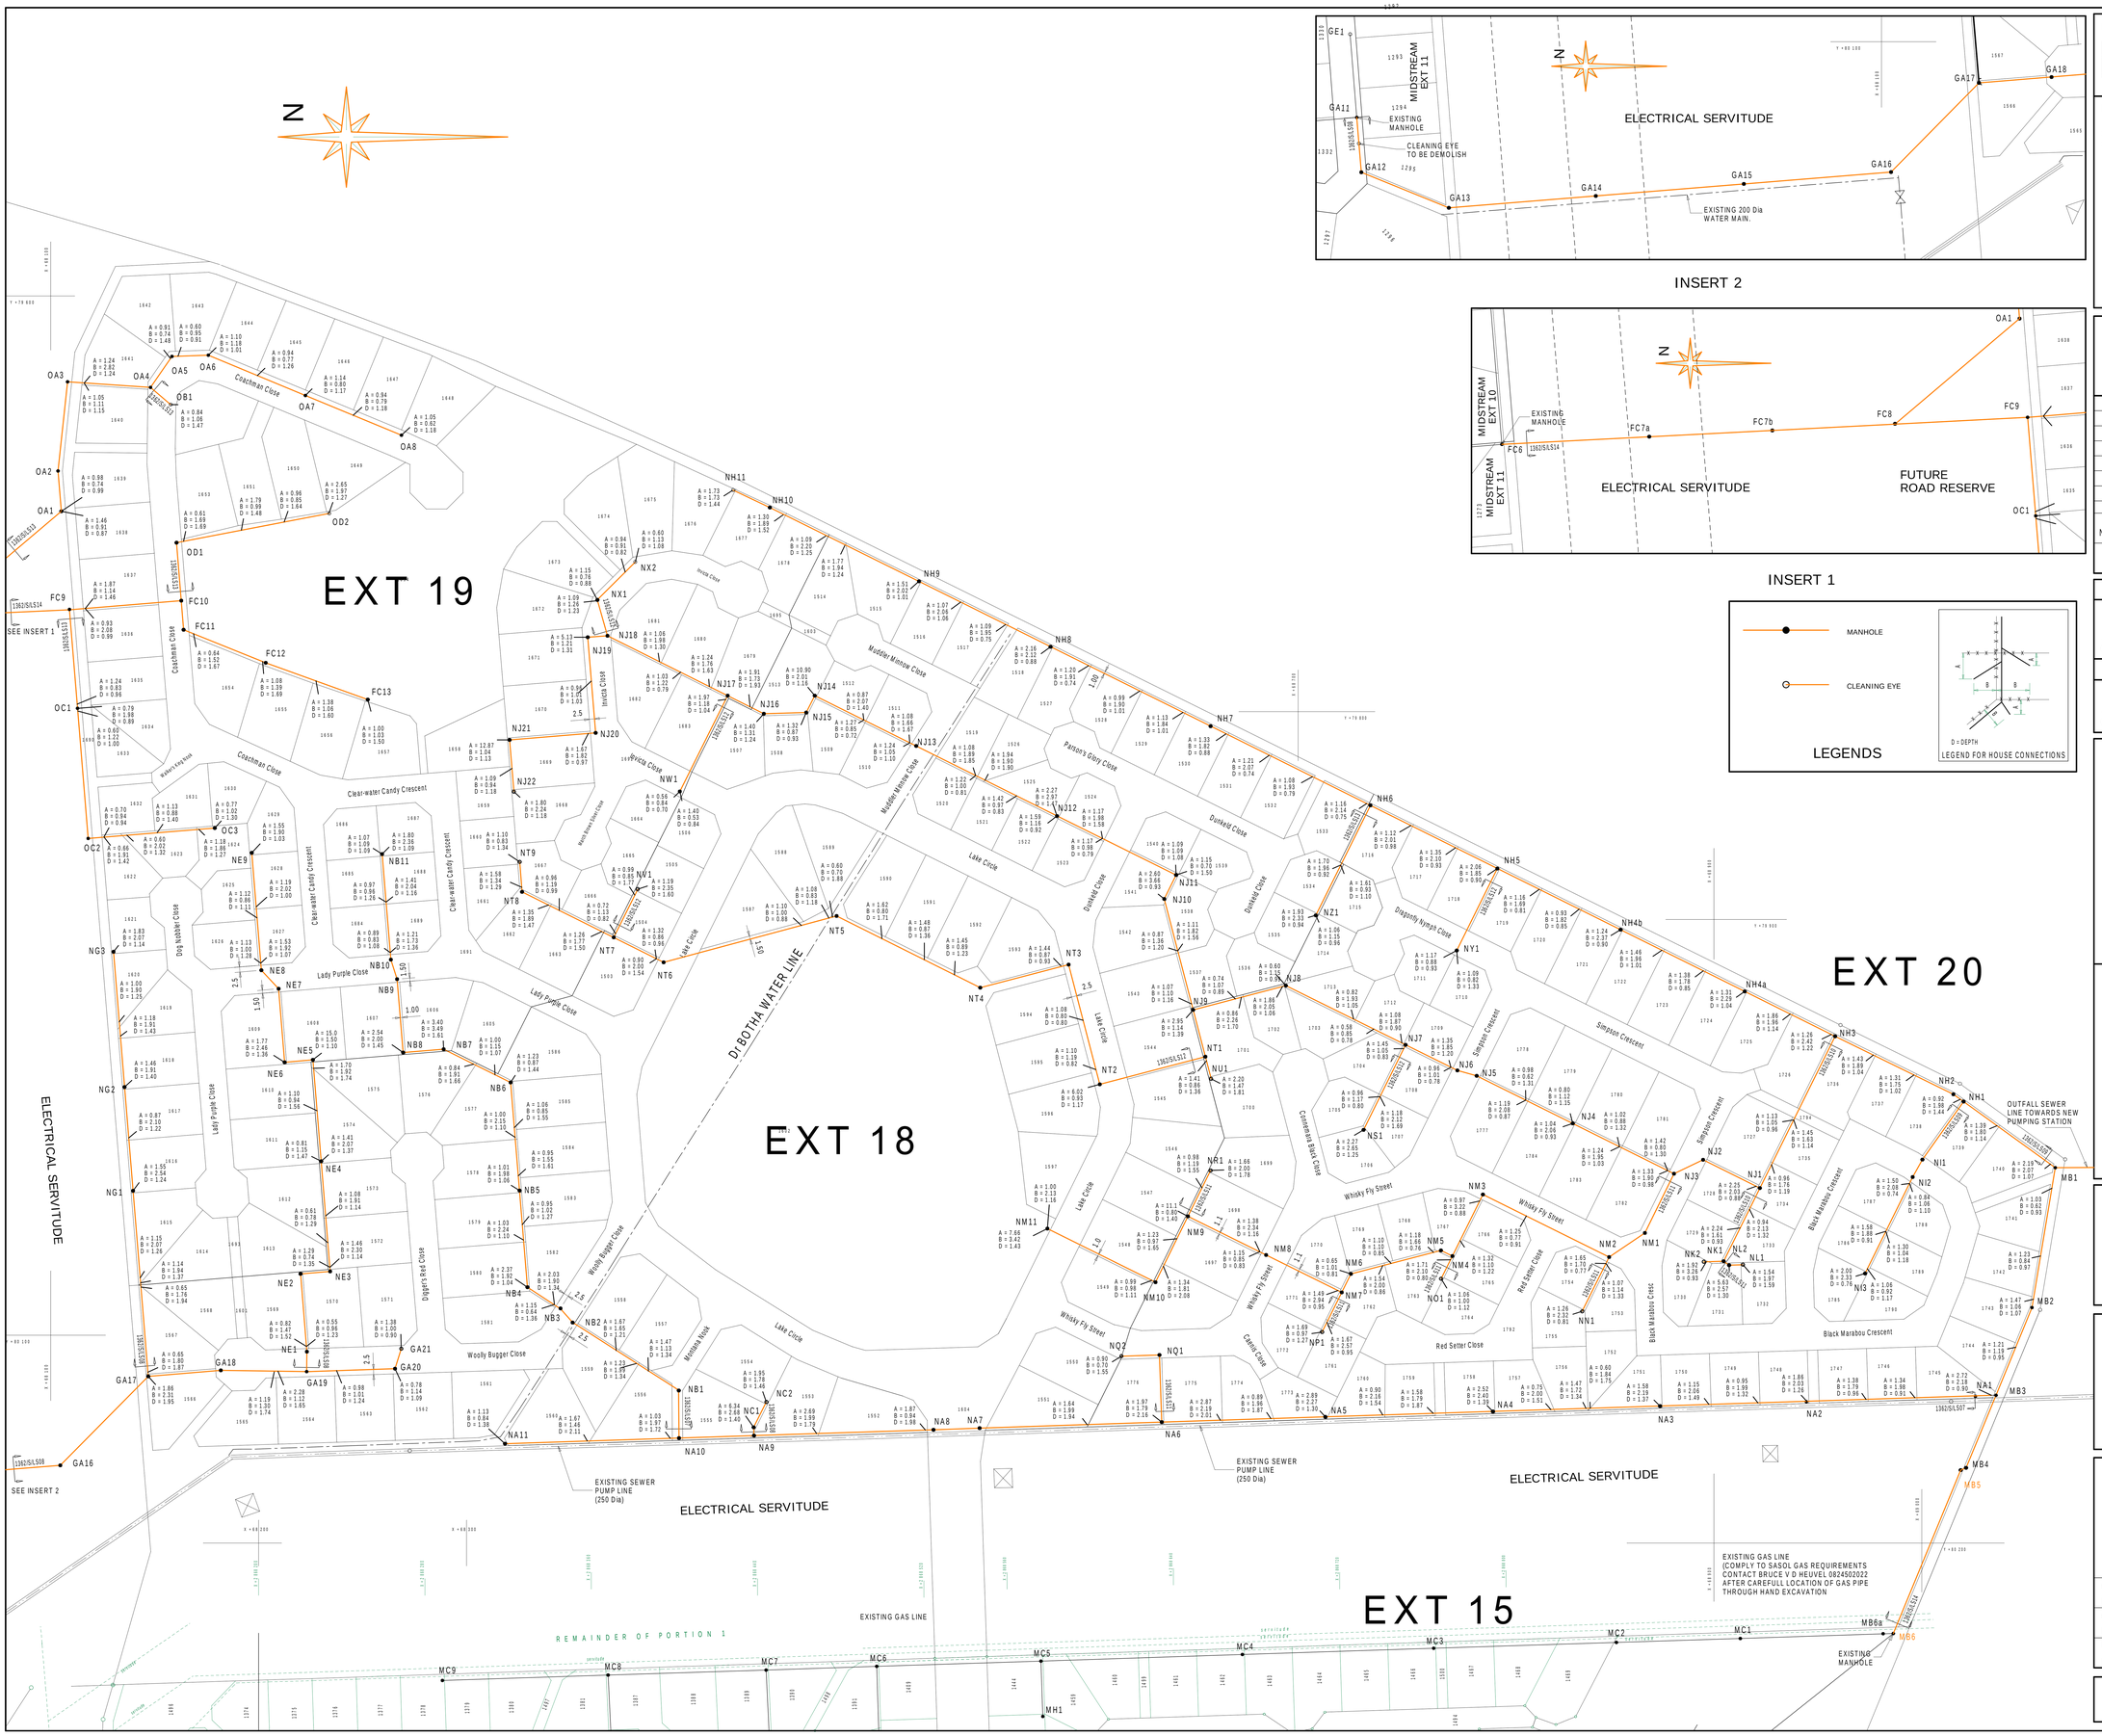

KLIENT/CLIENT

Bondev — Ontwikkelings (Edms) Bpk / Developments (Pty) Ltd.

NOTAS / NOTES

1. SEE TYPICAL DETAILS AND LONGSECTIONS
2. BENCHMARKS WILL BE PROVIDED PRIOR TO CONSTRUCTION.
3. DISTANCES OF PIPES CENTRE LINES FROM CADASTRAL BOUNDARIES AS FOLLOWS UNLESS OTHERWISE SHOWN:

i. MIDBLOCK = 1.0m
ii. ROAD RESERVES = 2.5m

Ekurhuleni METROPOLITAN MUNICIPALITY
Northern Service Delivery Region

NO	BESKRYWING/DESCRIPTION	DAT	NAAM NAME
5	AS BUILT LEVELS ADDED FOR EXT. 19	MAY 06	DE
4	AS BUILT LEVELS ADDED FOR EXT. 20	MAY 06	DE
3	AS BUILT LEVELS ADDED FOR EXT. 18	APR 06	DE
2	MH NN4a, NN4b, FC7a & FC7b ADDED. MH NM10, NM7 & NM2 MOVED. MH NN2 SHIFTED	NOV 05	DE
1	LINES FC6-OA6 & FC9-OC3 HAVE CHANGED.	OCT 05	DE

WYSIGINGS/REVISIONS

GOEDKEURING/APPROVAL

CITY ENGINEER — ASST. CITY ENGINEER

SOOS GEBOU/AS BUILT

CONSULTING ENGINEER — DATE/DATUM

DALING DE LANGE & VAN TONDER (Pty) Ltd
Raadgewende Siviele- en Strukturele Ingenieurs
Consulting Civil and Structural Engineers
POSBUS/P O BOX 49 — WAPADRAND 0050
TEL (012) 3476556 — FAX (012) 3472833

IN ASSOCIATION WITH / IN ASSOSIASIE MET :
VN THE CONSULTING ENGINEERS
15 UITZICHT OFFICE PARK, 1 BELLINGHAM ROAD, VERWOERDBURG — P.O. BOX 9320, HENNOPSMEER 0046
TEL (012) 665 0598 — FAX (012) 665 0398

PROJEK:
PROJECT:

MIDSTREAM ESTATE EXTENSIONS 18, 19 & 20 (MIDFIELD)

DIENSDETAIL:
SERVICE DETAIL:

SEWER LAYOUT

SKAAL OP VERKLEINDE TEKENING
SCALE ON REDUCED DRAWING

80mm OP OORSPRONKLIKE TEKENING
80mm ON ORIGINAL DRAWING

ONTWERP: DESIGN:	H.D.	NAGESIEN: CHECKED:	H.D.
GETEKEN: DRAWN:	DE	GOEDGEKEUR: APPROVED:	H.D.
DATUM: DATE:	SEPTEMBER 2005	SKAAL: SCALE:	1:1000

TEKENING NR. DRAWING NO. 1362/MF18/S1 (5)